


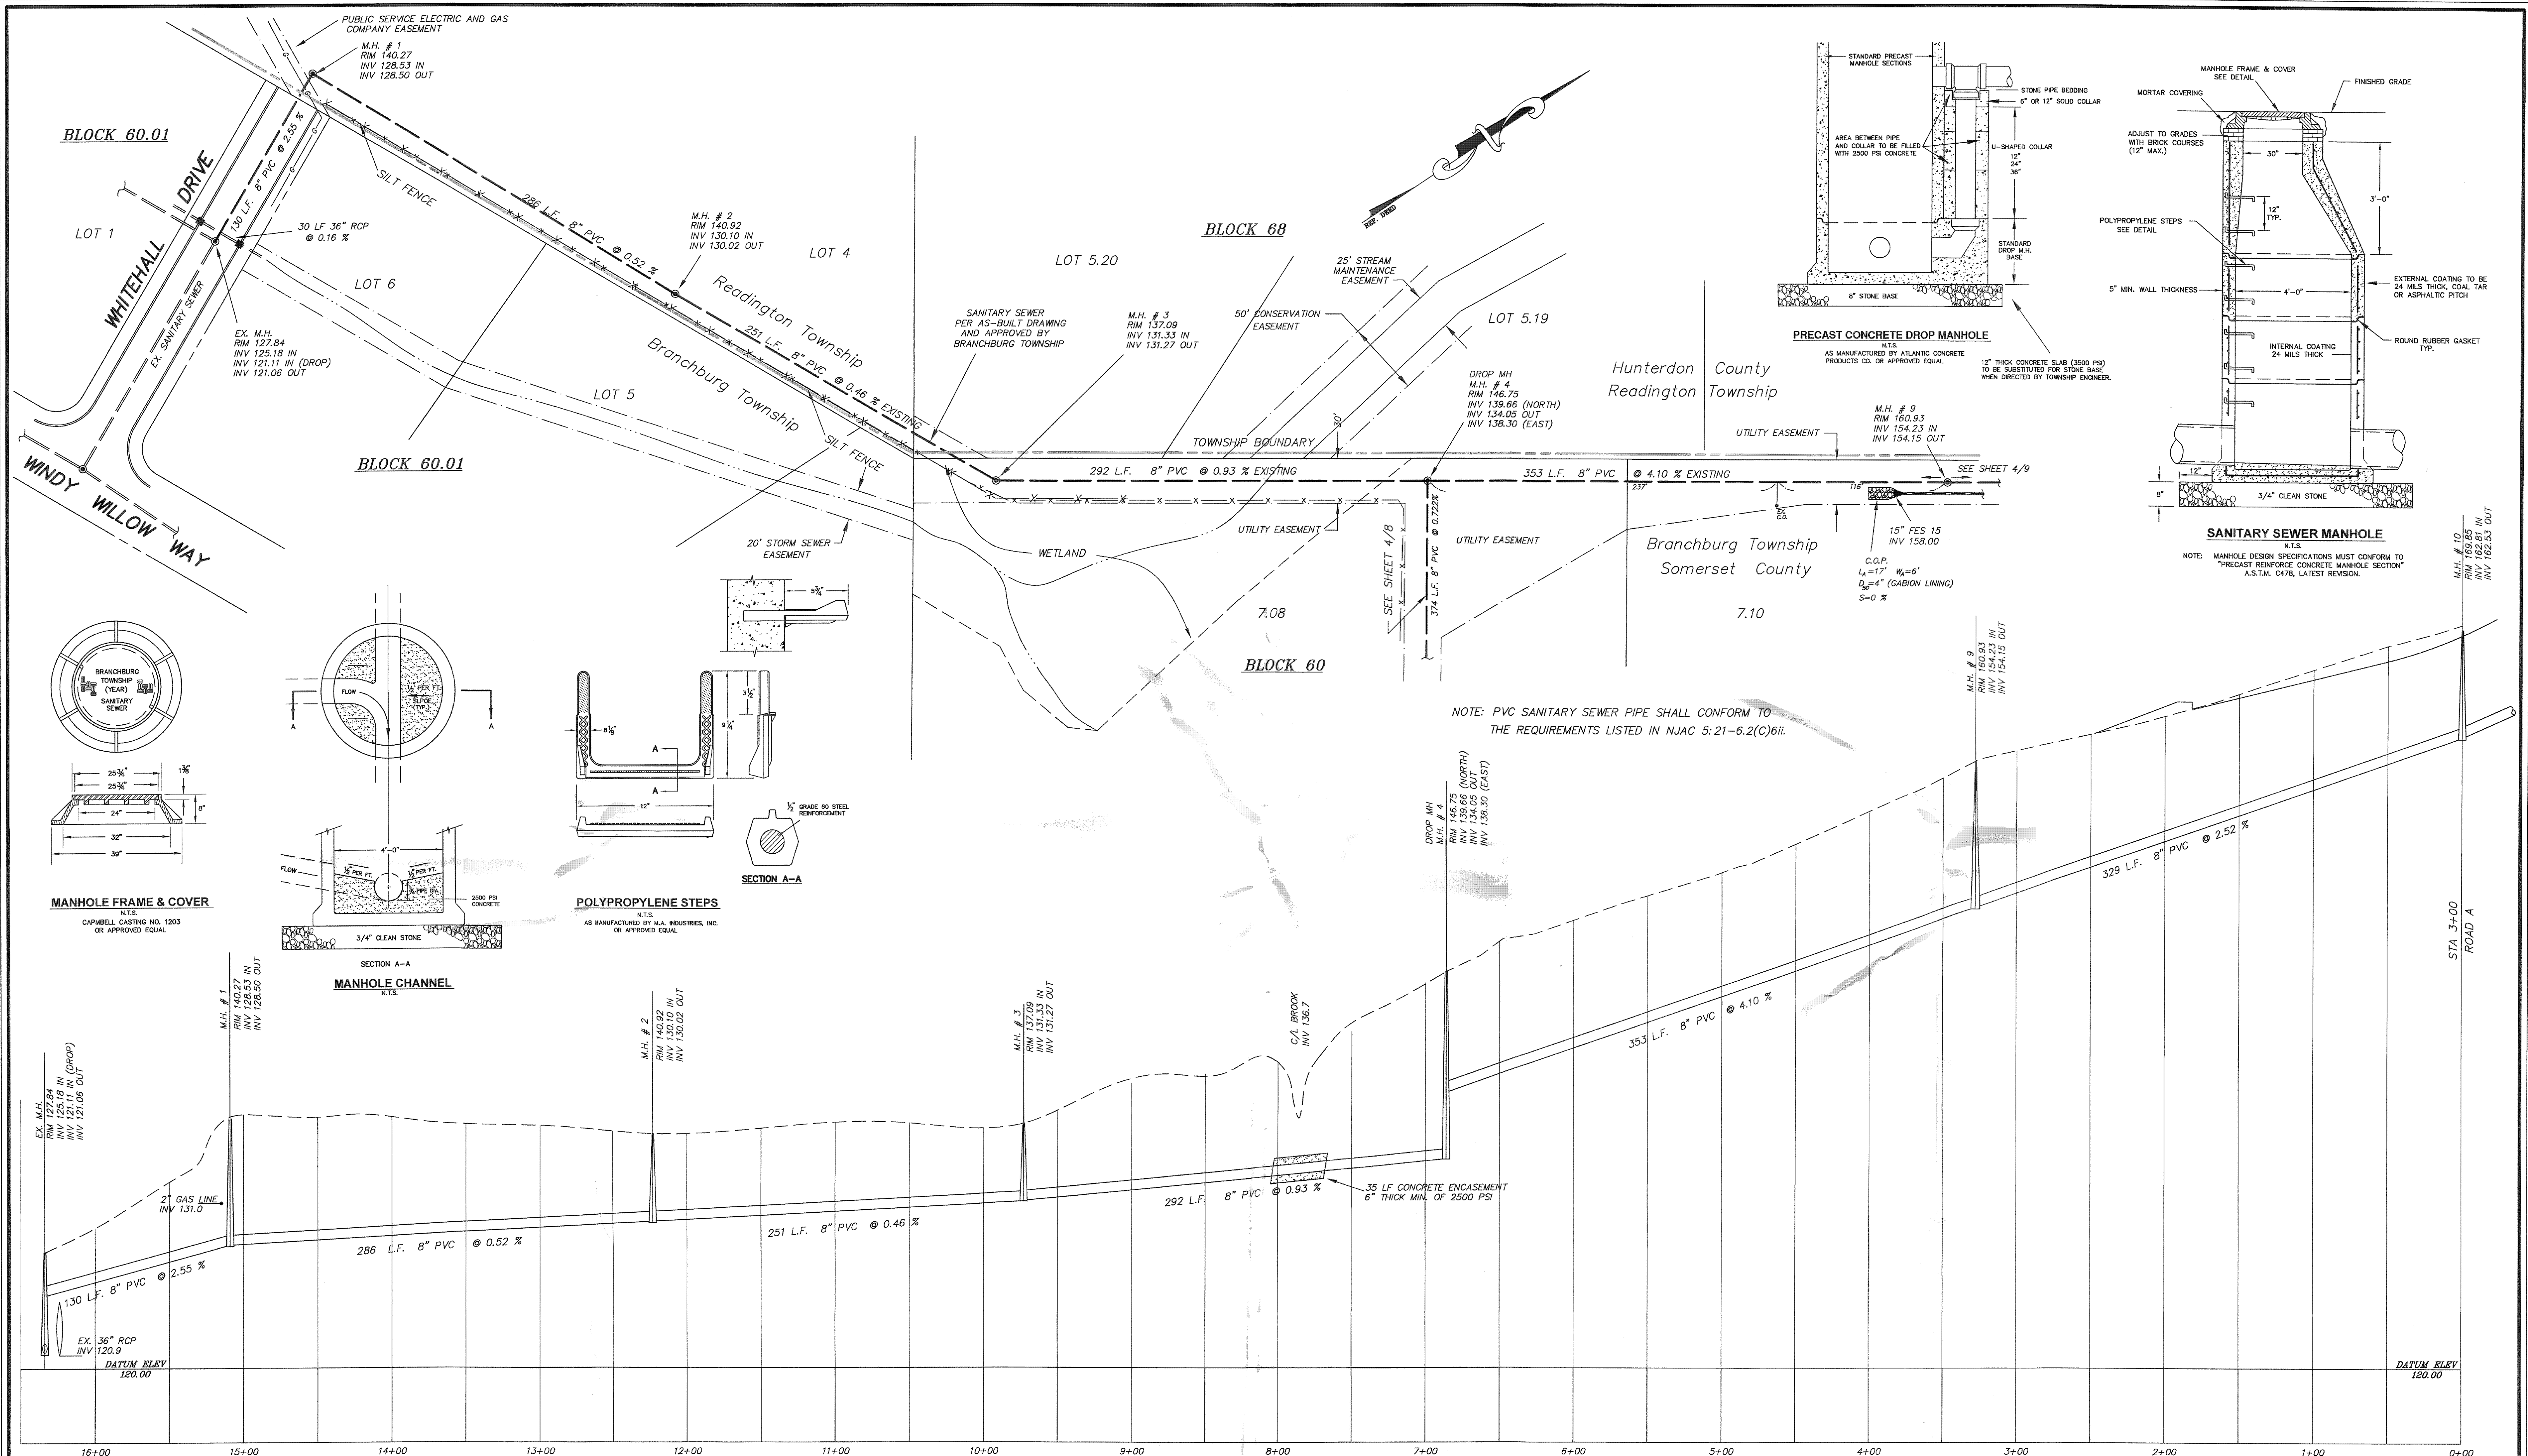

NOTE:

1. MANHOLE #4 SHALL BE RETESTED PRIOR TO ANY USE UPSTREAM OF MANHOLE #4.
2. A TRENCH INSPECTION OF THE EXISTING MAIN SHALL BE REQUIRED AS PART OF THE PERFORMANCE GUARANTEE OF THIS SUBDIVISION.
3. A MAINTENANCE BOND FOR A PERIOD OF TWO YEARS IN THE AMOUNT OF \$16,987.50 SHALL BE PROVIDED FOR THE EXISTING PORTION OF THE SANITARY SEWER PRIOR TO THE RELEASE OF THE FIRST BUILDING PERMIT.

PROFILE - SEWER EASEMENT 1

SCALE: 1" = 50' HORIZ.
1" = 5' VERT.

ALL CONSTRUCTION TO BE IN ACCORDANCE
WITH THE TOWNSHIP OF BRANCHBURG STANDARD
CONSTRUCTION DETAILS

REVISION	DATE
10 LOTS	11-2-05
ROAD SHIFT	1-23-06
ADD SILT FENCE	10-1-07
PER REVIEW	12-20-07
PER REVIEW/AS BUILT	12-29-14
ENGINEERS REVIEW	3-29-15
ENGINEERS REVIEW	7-10-15
ENGINEERS REVIEW	8-31-15
ENGINEERS REVIEW	10-14-15

Templin Engineering Associates
Engineering - Surveying
861 EISENHOWER AVENUE
BRIDGEWATER, NJ 08807
PHONE: (908) 231-1616 FAX: (908) 231-1894

Robert J. Templin
Robert J. Templin
PROFESSIONAL ENGINEER AND LAND SURVEYOR
N.J. LIC. # 25136

PROFILE - SANITARY SEWER EASEMENT			
PRELIMINARY MAJOR SUBDIVISION OF			
BLOCK 60 LOT 7			
FLATWATER DEVELOPMENT, INC.			
BRANCHBURG TOWNSHIP, SOMERSET COUNTY			
NEW JERSEY			
DESIGNED BY:	CHECKED BY:	FILE NO.	SHEET NO.
DRAWN BY: T.M.	SCALE: AS SHOWN	DATE: 2-5-04	03-013 5/11